


I I I I I I

PARKING GARAGE

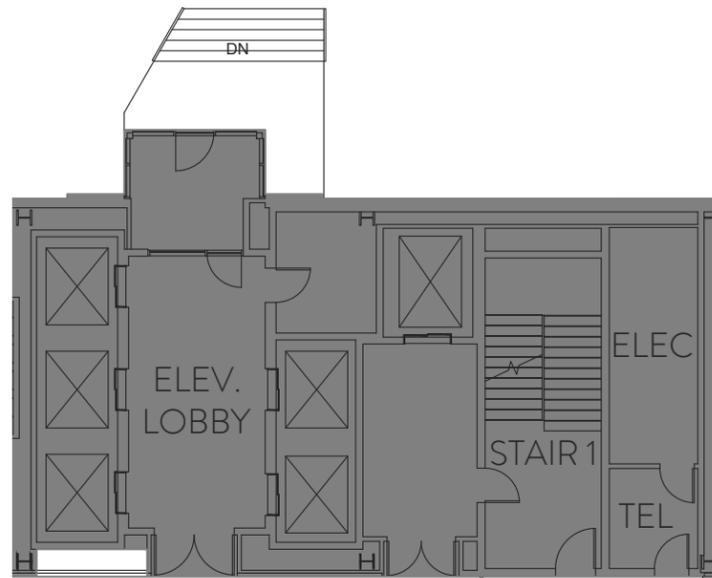

SUITE 325

SUITE 300

SUITE 330



3rd Floor @ Capitol View Block E

AS-BUILT

ISSUE DATE: 12.12.2025

